




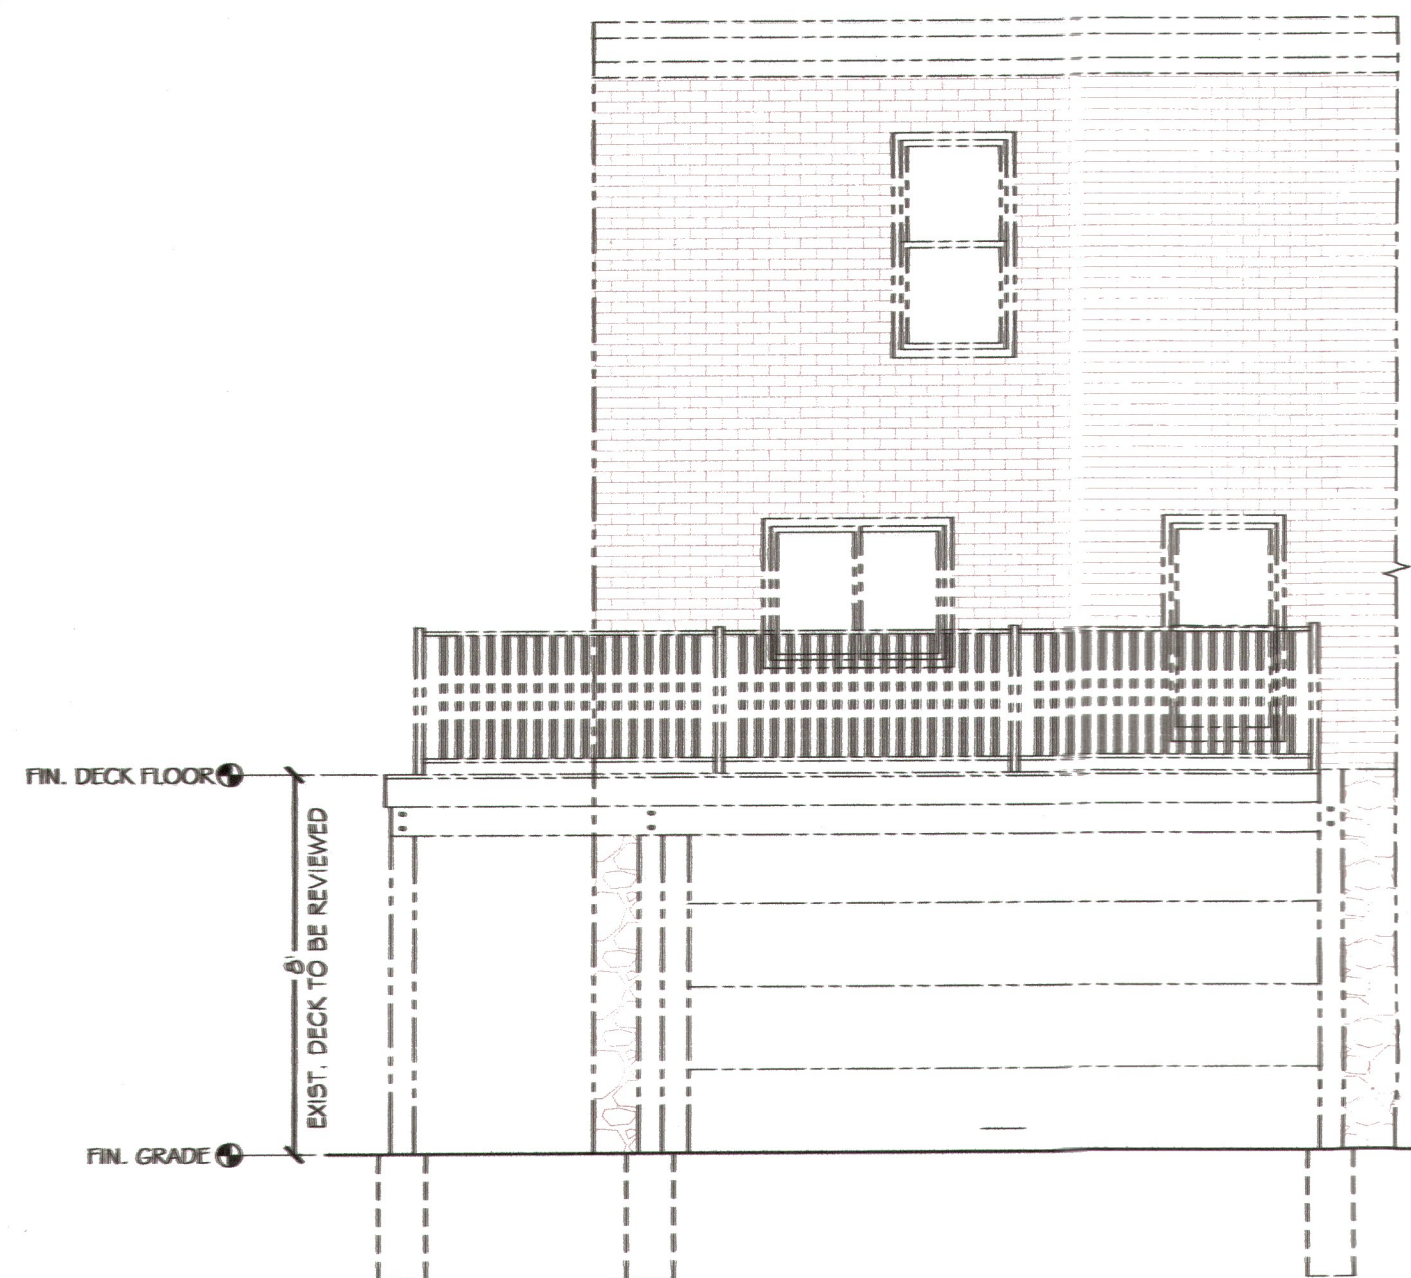

4 REAR ELEVATION
AI SCALE: 1/4" = 1'-0"

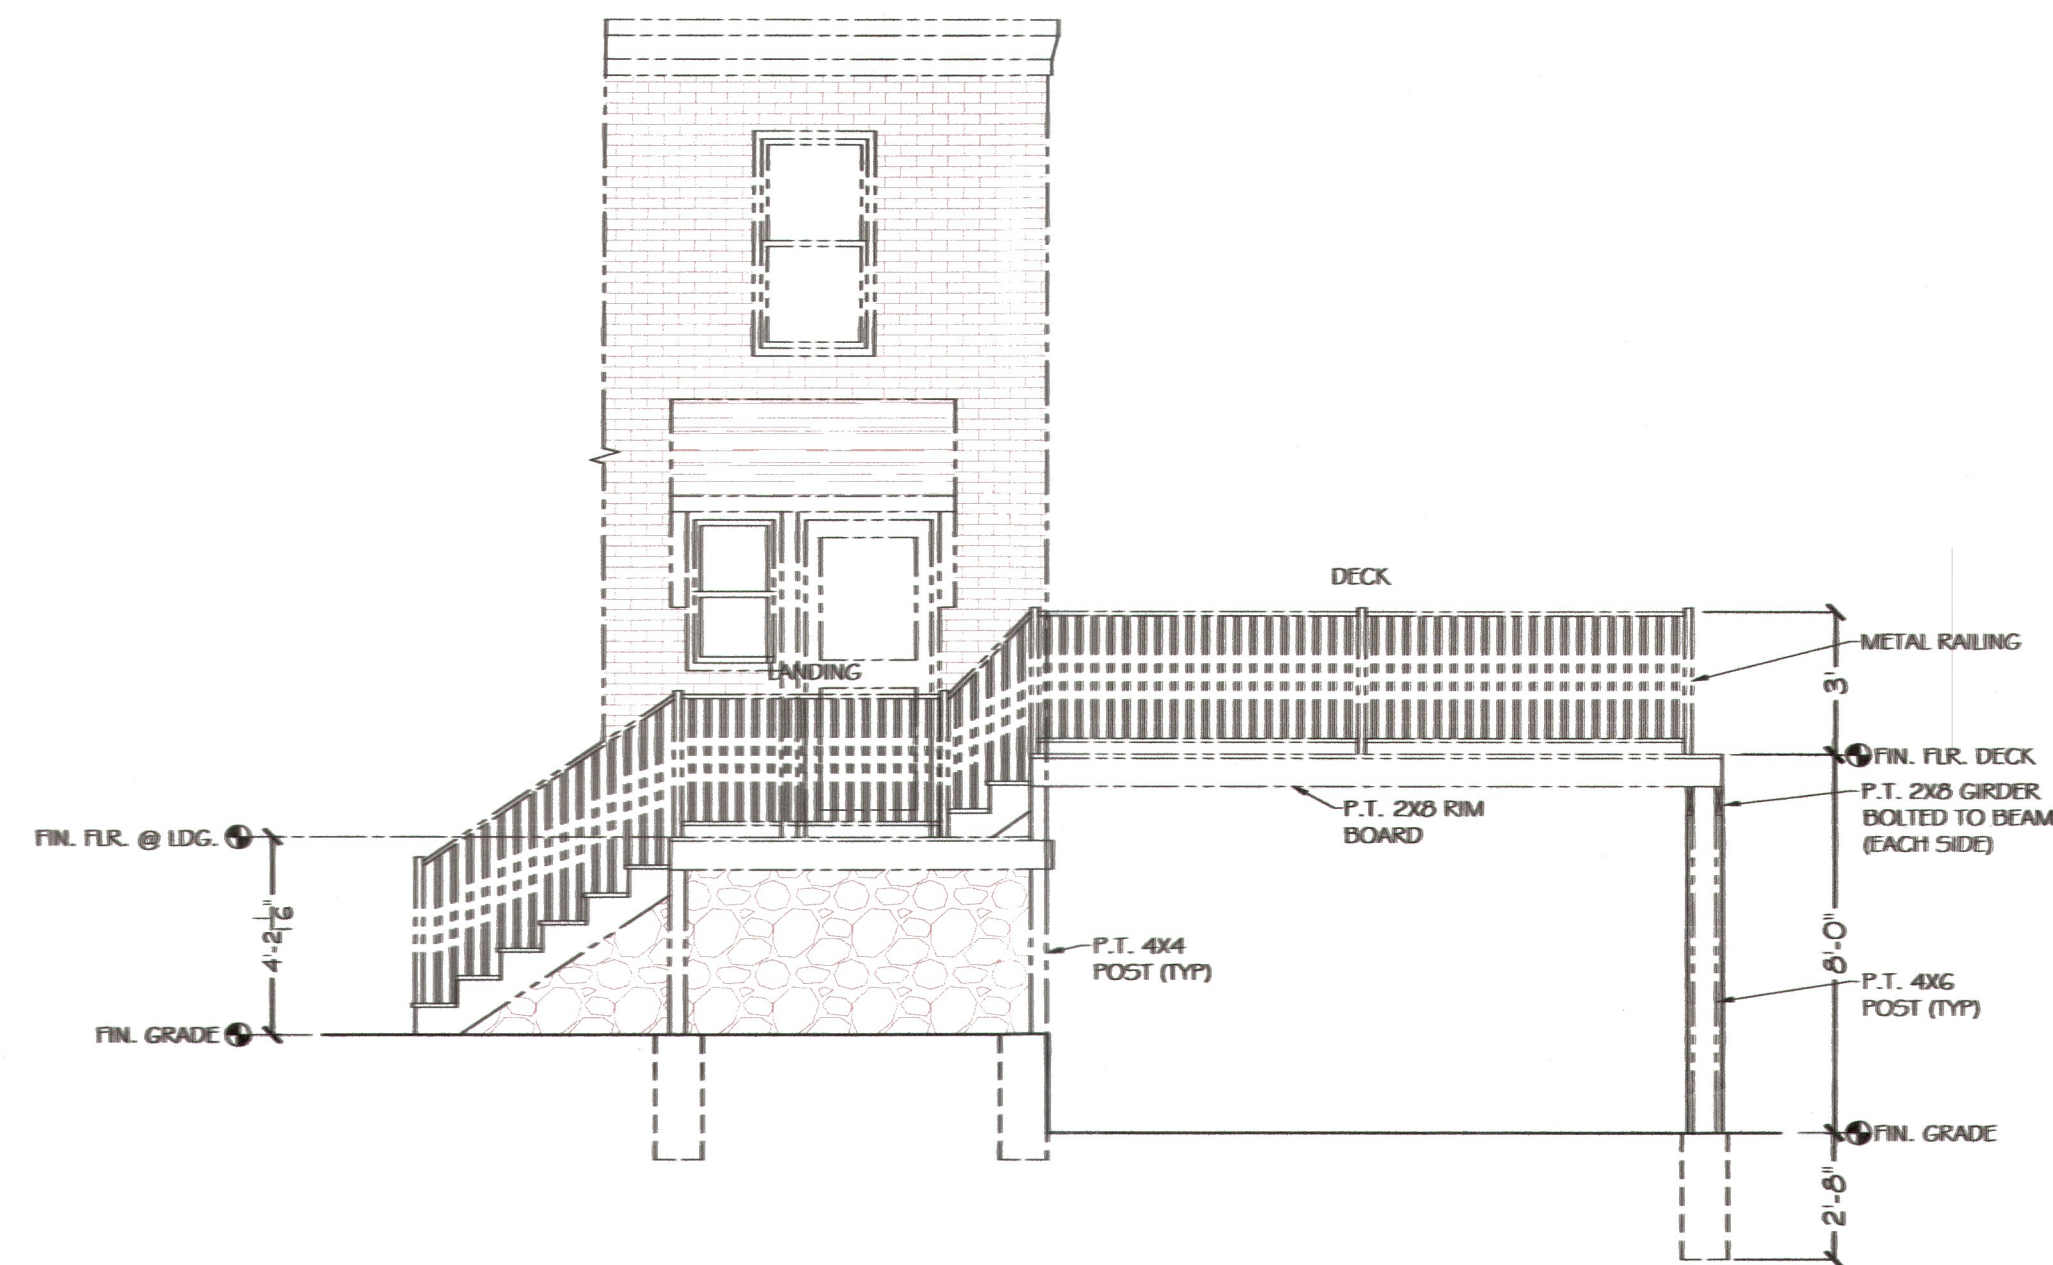

5 LEFT SIDE ELEVATION
AI SCALE: 1/4" = 1'-0"

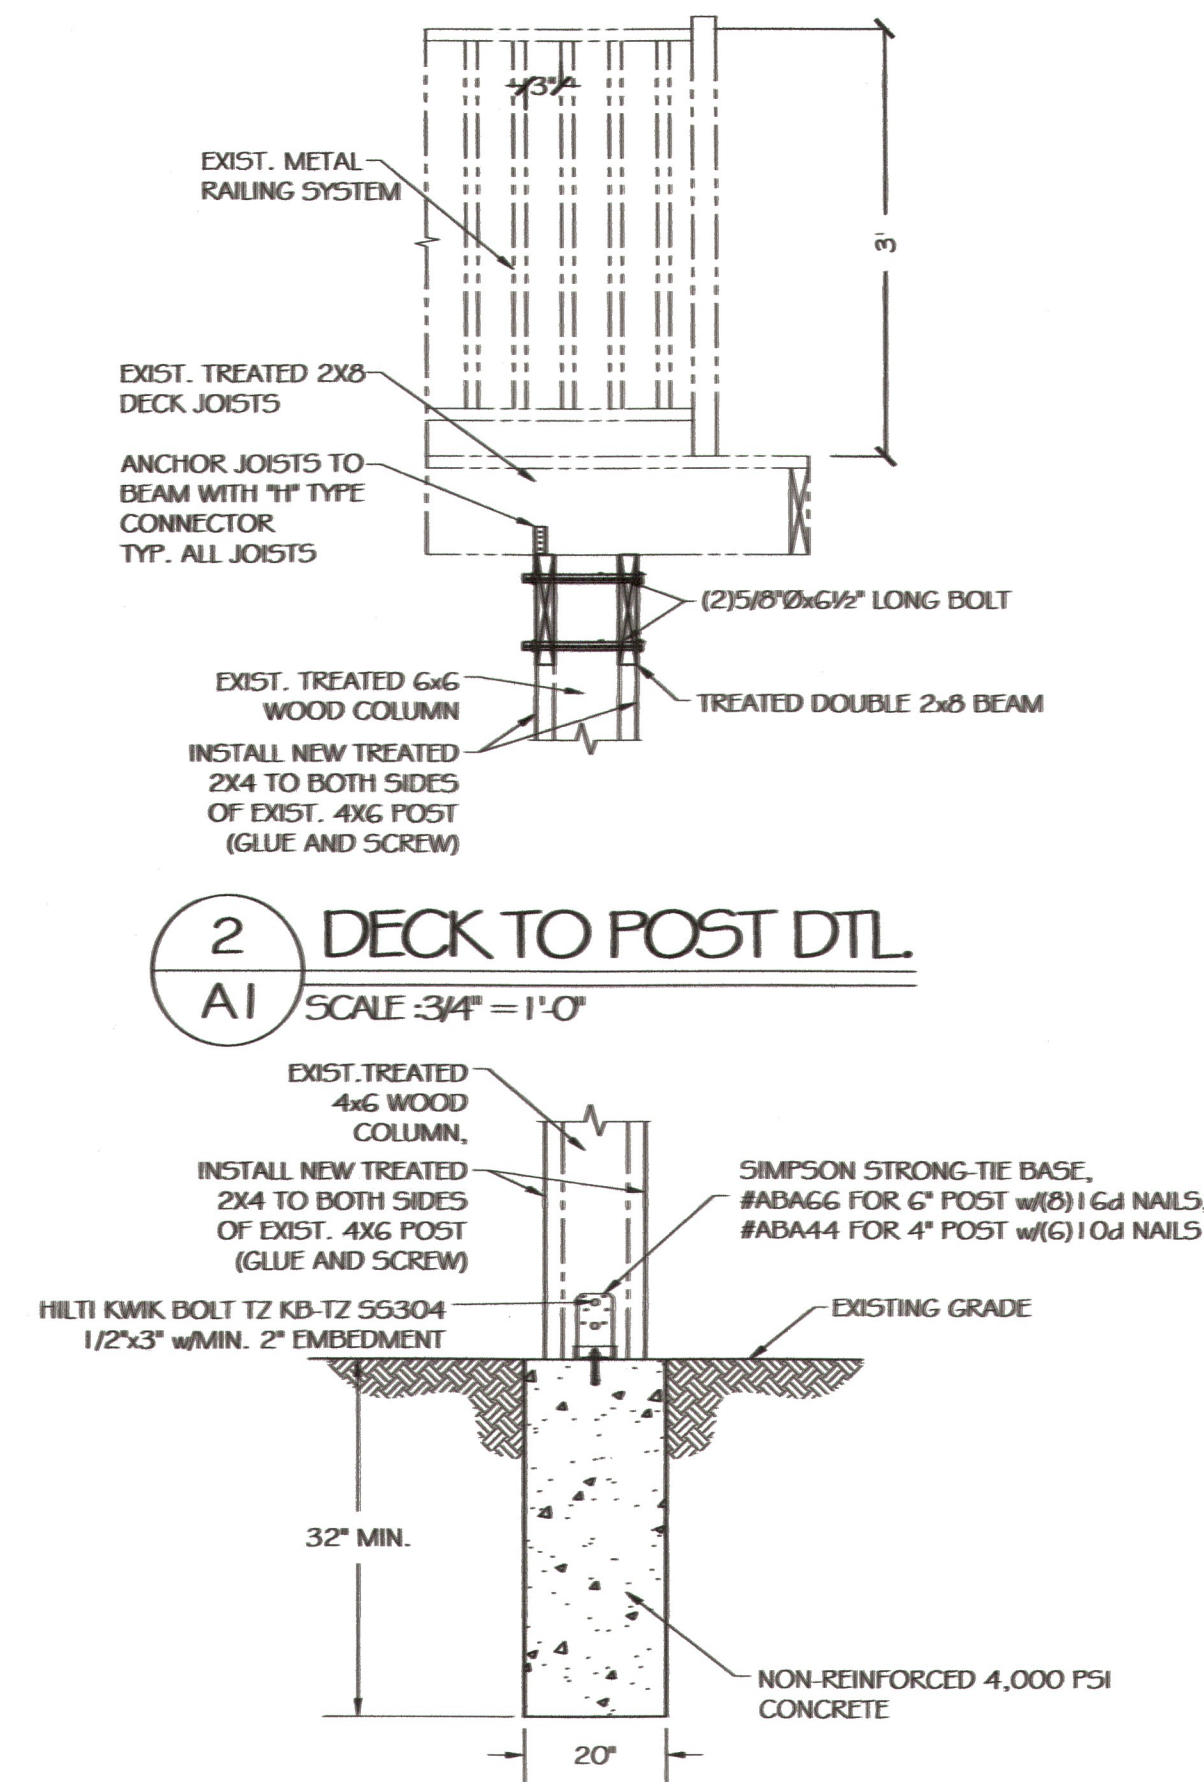

2 DECK TO POST DTL.
AI SCALE: 3/4" = 1'-0"




3 POST TO FTG. DTL.
AI SCALE: 1" = 1'-0"

DALE GRAHAM
CAD DESIGN
Residential & Commercial
Design
Facility Documentation
Historical Architectural
Preservation
M.E.P. Design
5 Mateo Circle
Wilmington, DE 19804
302-415-5809 - Cell
grahamdale911@gmail.com

Engineer / Architect:

ALPHA ENGINEERING INC.
P.O. BOX 688 BEAR DE, 19701 800-292-7047
WWW.ALPHA-ENGINEERING.COM (302) 834-3344 FAX (302) 834-3883

ENGINEER'S SEAL

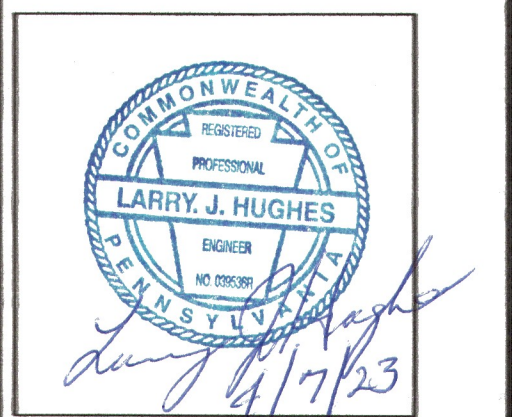

I HEREBY CERTIFY THAT THESE DOCUMENTS WERE PREPARED OR APPROVED BY ME, AND THAT I AM A DULY LICENSED ENGINEER UNDER THE LAWS OF THE STATE OF PA.
License No. 039536R
Exp. Date:

No. REVISION / ISSUE DATE

CLIENT NAME & ADDRESS:

Simpson Residence
308 E. Allens St.
Philadelphia, PA.
19119

PROJECT NAME & ADDRESS:

Asbuilt Deck Plans
308 E. Allens St.
Philadelphia, PA.
19119

DRAWING NAME:
Floor Plans

DRAWN BY: DG
CHECKED BY: DG

PROJECT#: SHEET#:

DATE: 04-06-23
SCALE: AS NOTED

A2